


GA LEGEND	
	OUT OF SCOPE
	CENTRELINE DIMENSION
	CLEAR OPENING DIMENSION
	DOOR NUMBER TAG
	Room ROOM NAME ROOM NUMBER
	NEW PARTITION
	EXISTING PARTITION / WALL / STRUCTURE
	J10 JOINERY TAG
	RAISED ACCESS FLOOR

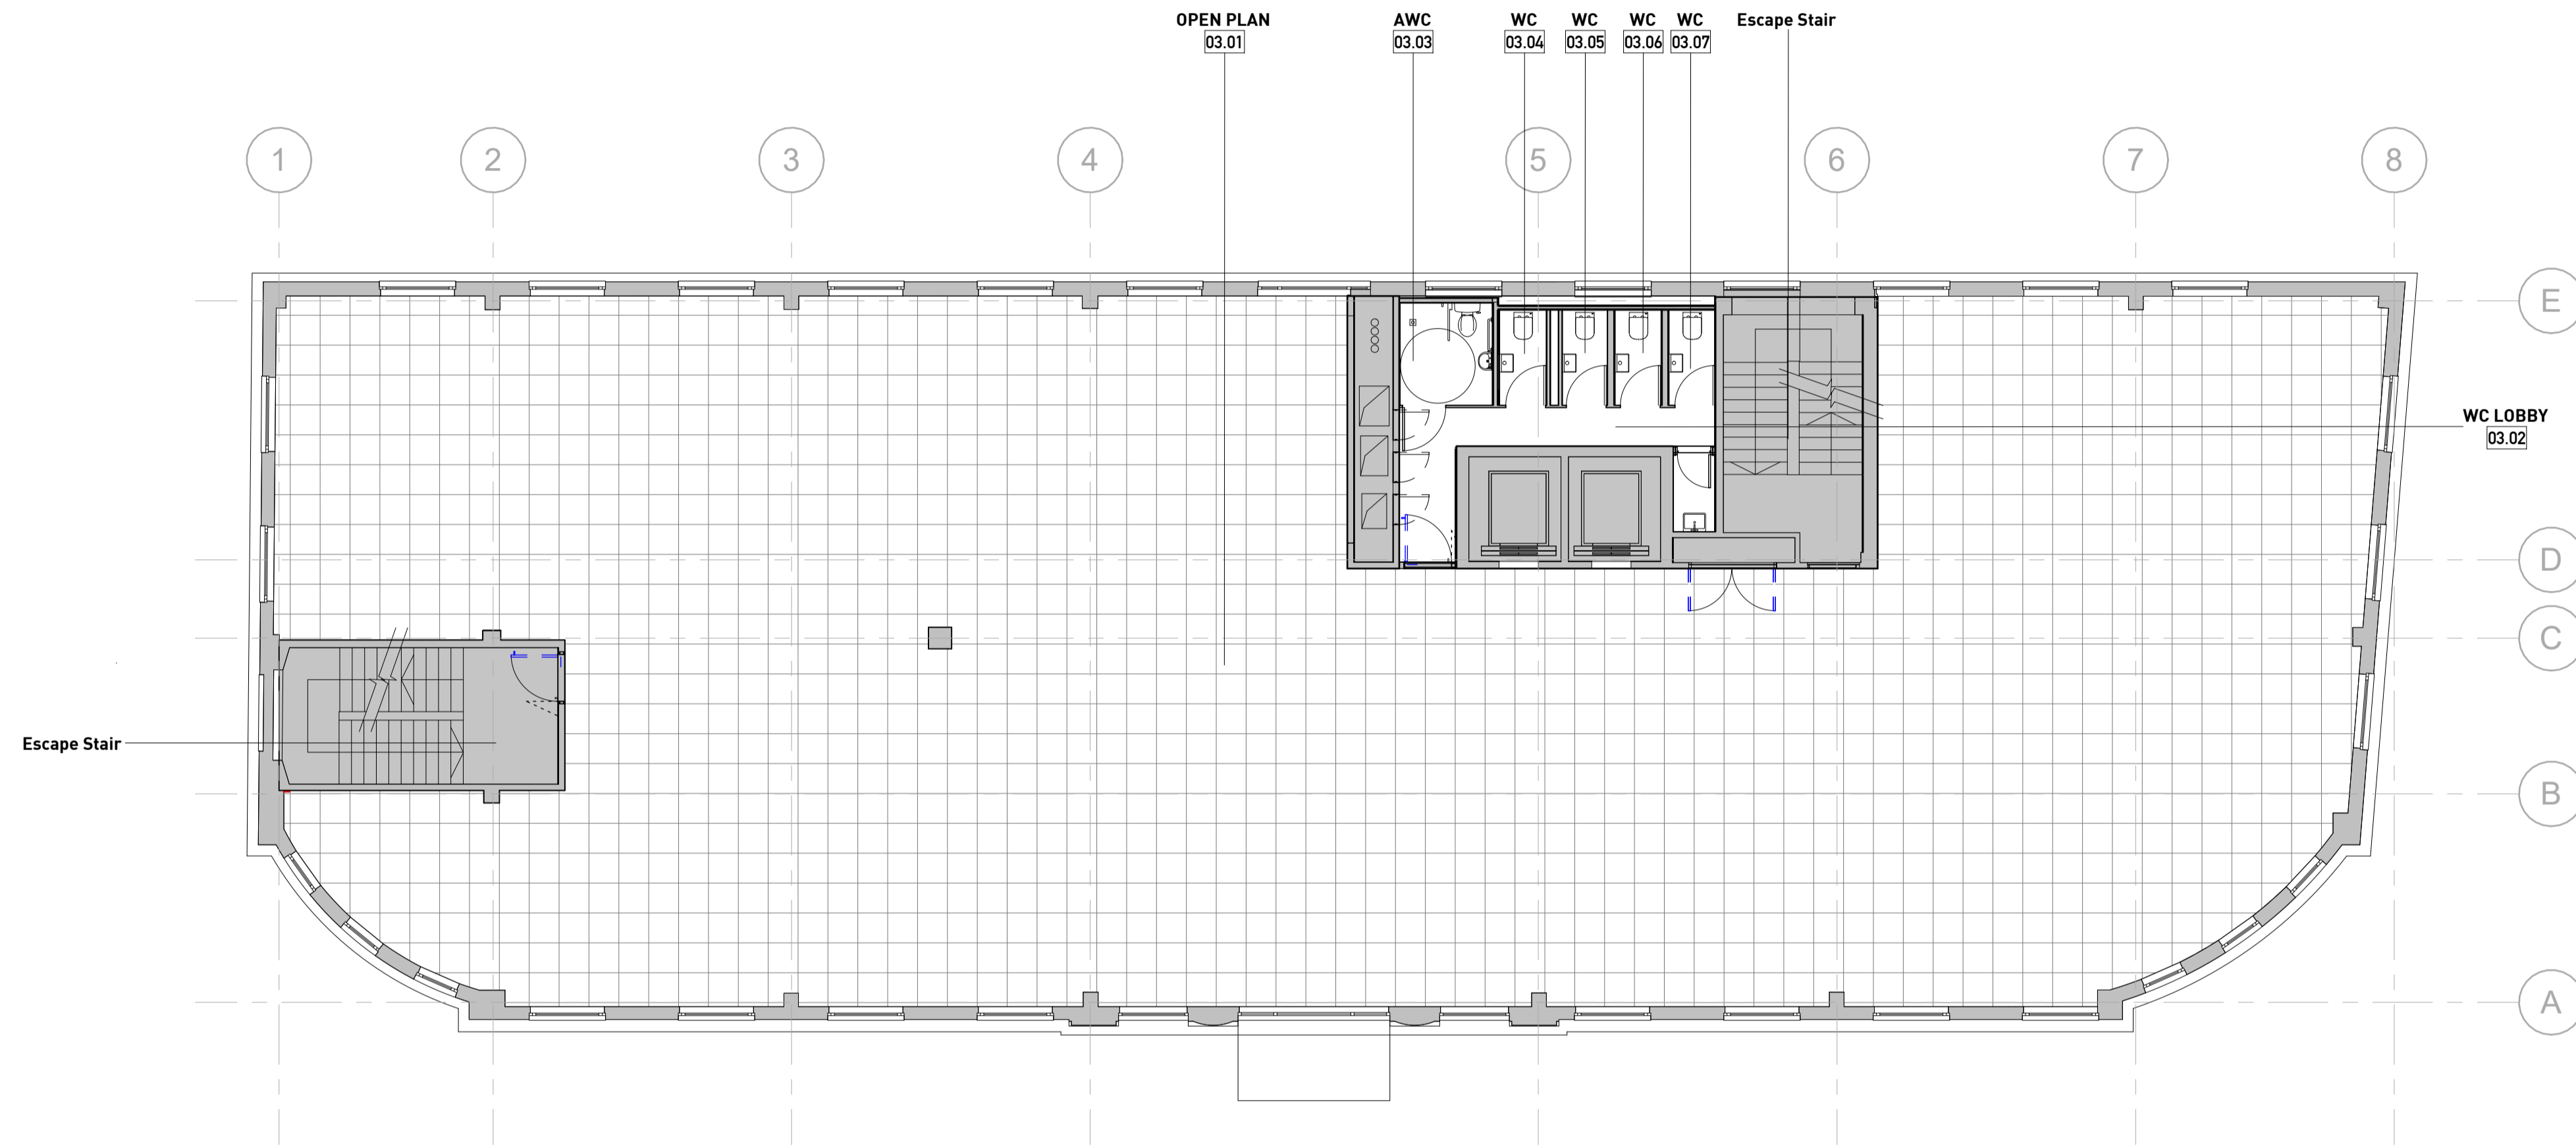

REVISION	DATE	DESCRIPTION
AB1	28.03.23	AS BUILT

CLIENT  
**EURO GROUP**

PROJECT  
**70 GRAYS INN ROAD  
LONDON WC1X 8NH**

QBRE PROJECT NUMBER  
**38001**

SCALE @ A1	SCALE @ A3
1 : 100	1:200 DO NOT SCALE

STATUS  
**PRECONSTRUCTION**

DRAWING  
**LEVEL 03 GA - CAT A**

DRAWING NUMBER	ISSUE
<b>38001-L3-101</b>	<b>AB1</b>

