


**Architectural Record Set**  
 THESE DRAWINGS ARE TO BE READ IN CONJUNCTION WITH THE FOLLOWING CONSULTANT RECORD DRAWINGS AND SUBCONTRACTOR INFORMATION:

CONSULTANT PACKAGES:  
 STRUCTURAL AND CIVIL DESIGN: WALSH  
 SERVICES DESIGN: MAX FORDHAM LLP  
 FIRE: TRIGON

SUBCONTRACTOR PACKAGES:  
 PRECAST CLADDING: TECHCRETE  
 WINDOWS & DOORS: PRATER  
 CURTAIN WALLING: LONDON ARCHITECTURAL GLAZING  
 RAINSCREEN CLADDING: DIMITRO  
 BALCONIES: SAPPHIRE  
 ELECTRICAL INSTALLATION: WHEELER ELECTRICAL  
 MECHANICAL INSTALLATION: H&V SERVICE PLAN  
 KITCHENS (IMPERIAL COURT): FLAWLESS  
 ARCHITECTURAL METALWORK: STEELBUILD

**PLEASE NOTE DESIGN DIMENSIONS SHOWN MAY DIFFER FROM WHAT HAS BEEN BUILT DUE TO SITE CONDITIONS.**

Rev	Description	Date
P1	FIRST ISSUE	03.04.20
C1	UPDATED IN LINE WITH UNIT PLANS & FIRE STRATEGY	10.12.20
C2	DOOR REFS ADDED & FLAT A REVISED	13.05.21
C3	COORDINATION ISSUE	20.08.21
C4	A1 DOOR ADDED	17.09.21
C5	A1 REFUSE STORE REVISED	01.11.21
R1	RECORD ISSUE	01.04.22

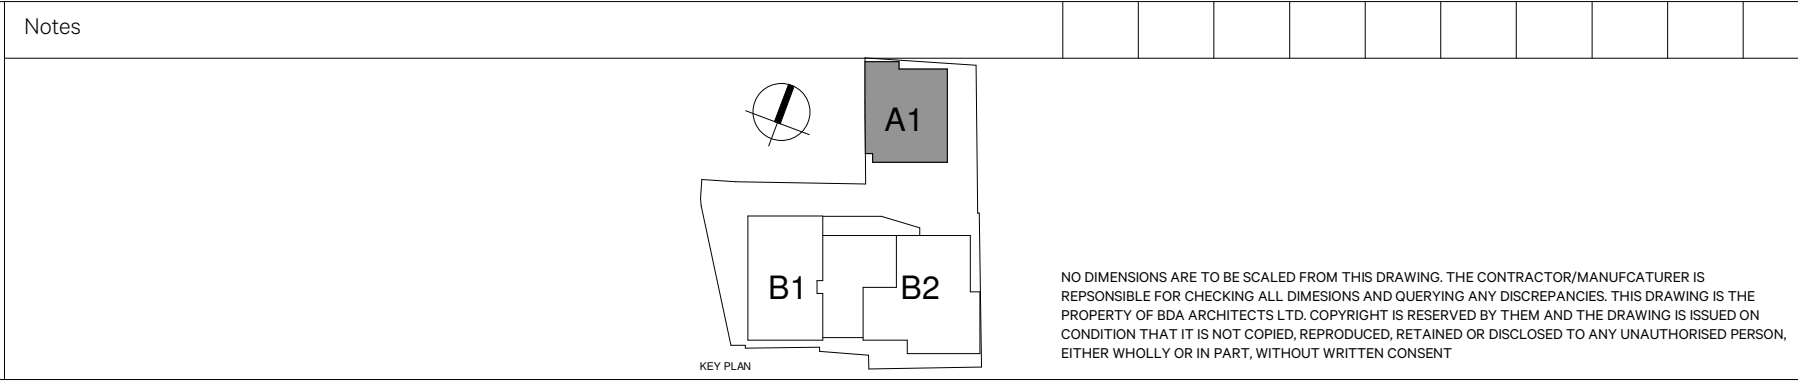

Client	HOLLYBROOK HOMES
Project	OSIERS ROAD
Drawing	BLOCK A1 - 00 GROUND FLOOR
Scale (@A1)	1:50
Date	04/02/20
Drawn	BA
Checked	SP
Project & Drawing No.	0830-BA- A1-00-DR-A-0101
Revision	R1

**Burwell Architects**

info@burwellarchitects.com  
 www.burwellarchitects.com

Unit 0001  
 California Building  
 London SE13 7SF  
 +44 (0) 2083 056010