



**NOTES:**

1. All sizes to be taken and checked on site by contractor prior to preparation of shop drawings or fabrication of parts.
2. This drawing should not be scaled. Any discrepancies to be brought to the immediate attention of the Contract Administrator.
3. All services to Local Authorities, Building Control Officer and Environmental Health requirements and to Service Engineer's details.
4. All structure to Structural Engineer's details and Local Authority and Building Control Officer's requirements.
5. All construction and materials to comply with current Building and Fire Regulations.
6. The Contractor shall comply with the CDM 2007 Regulations.

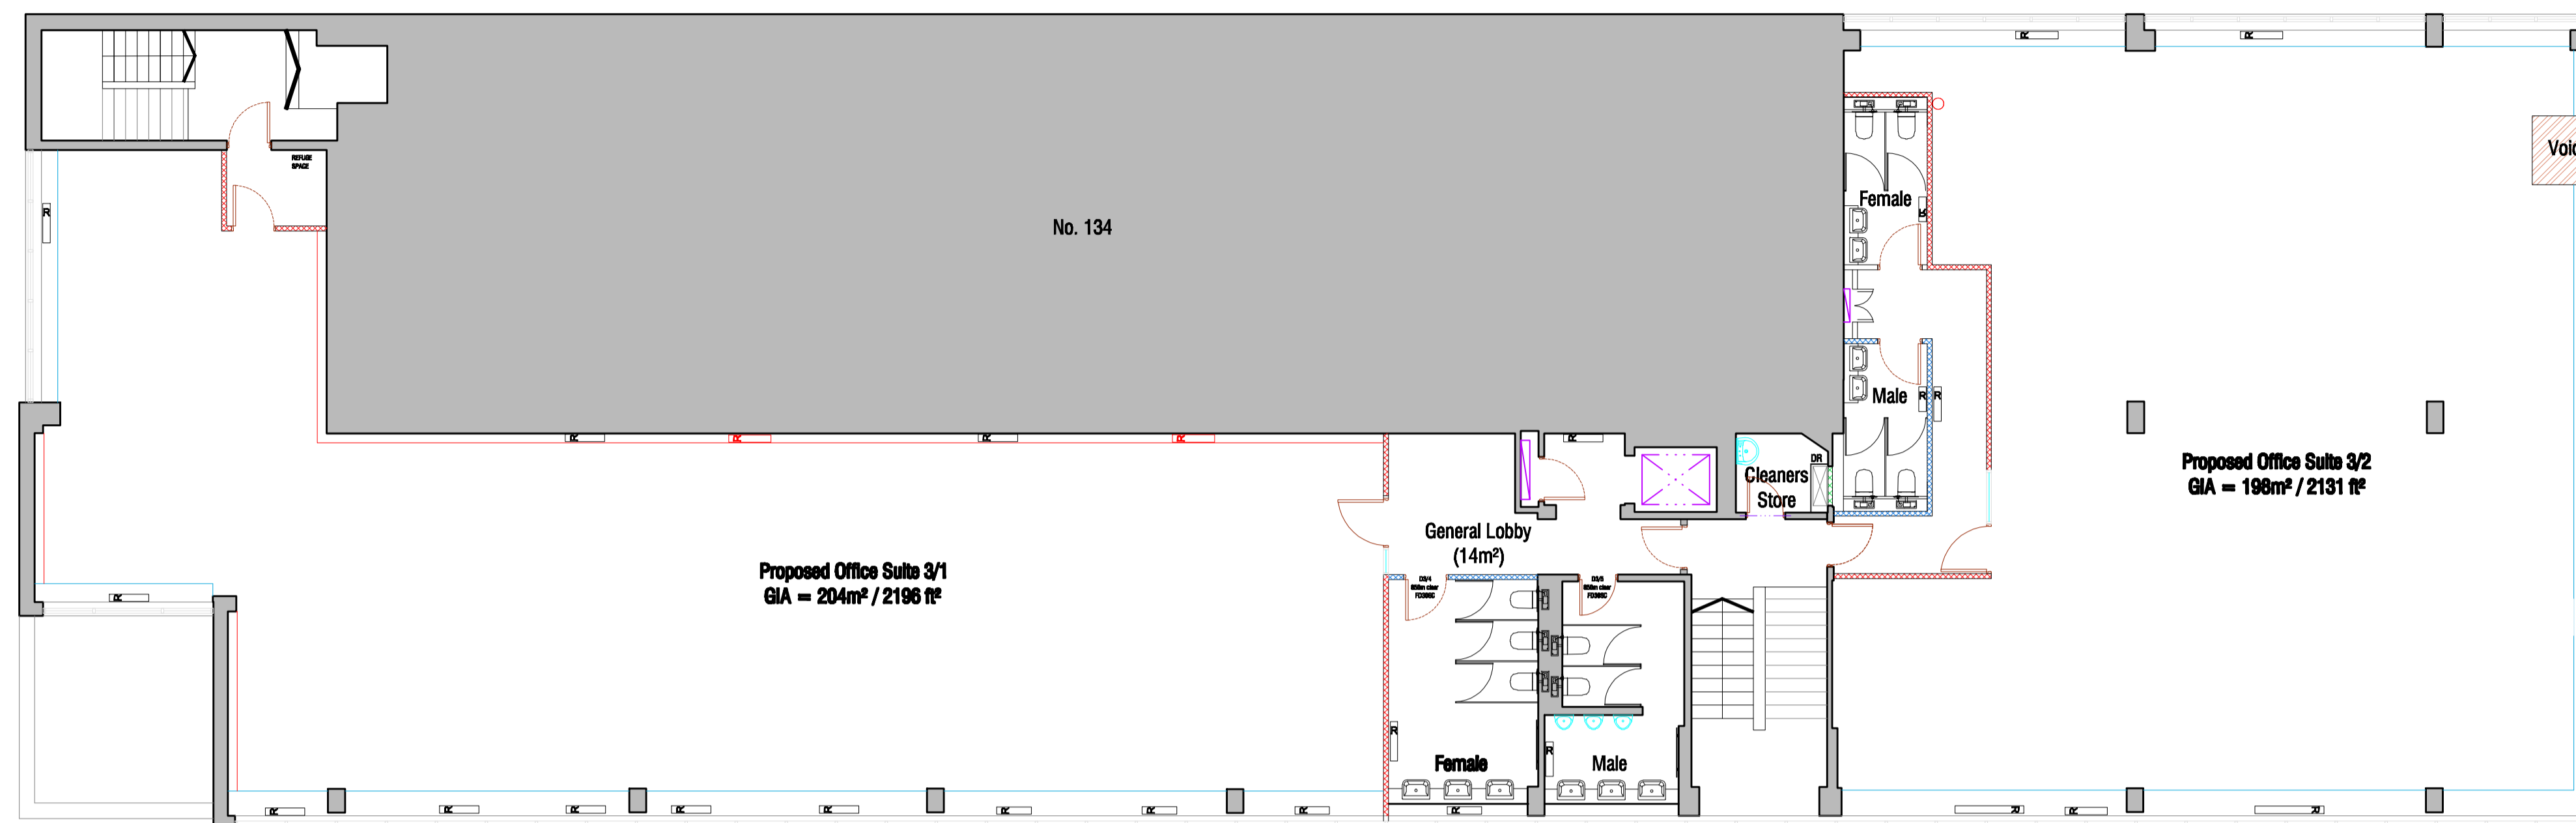

Third Floor as Proposed

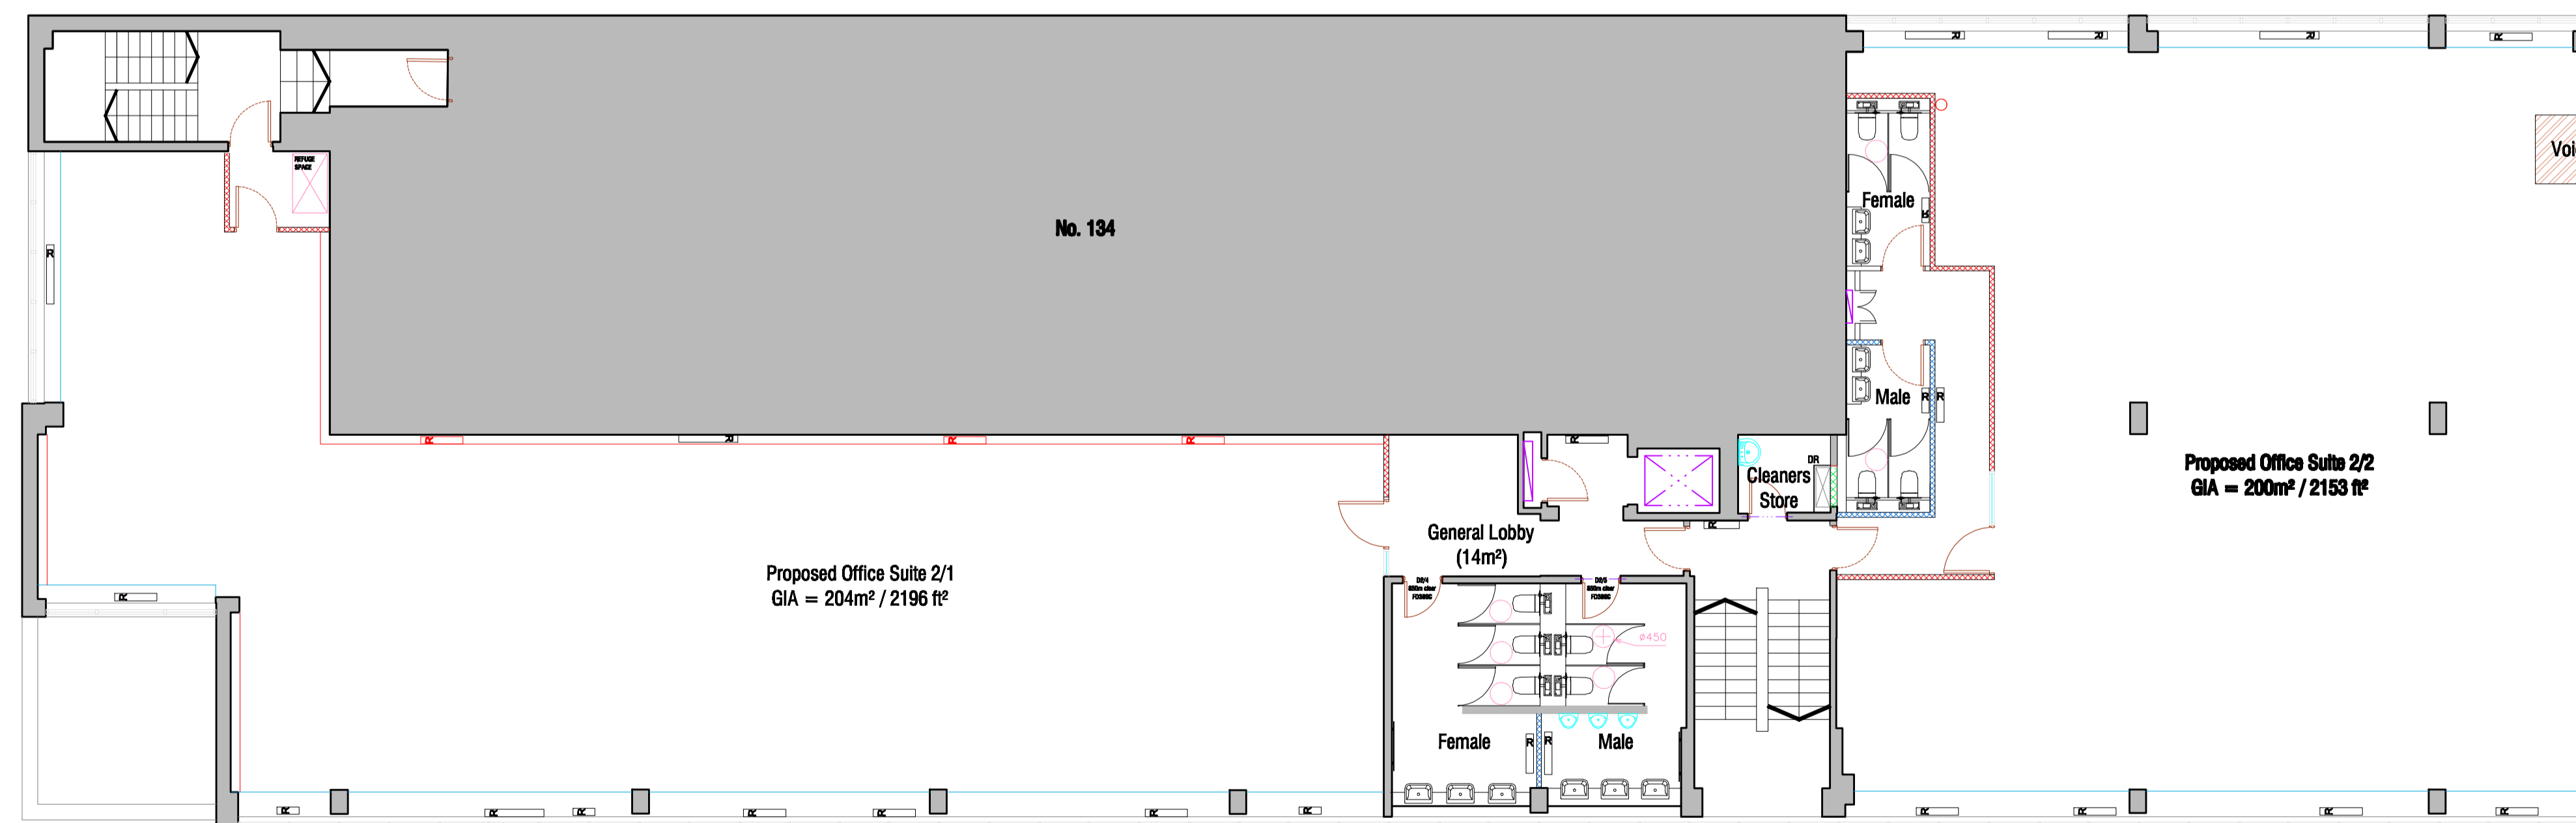

Second Floor as Proposed

As Built

Revision:	Description	Date

Title: **Second / Third Floor Layouts As Proposed**


Property: **132-134 Seagate Dundee**

Client: **Seagate Enterprise LLP**

Scale: **1:100@A1** Date: **29/07/11**

Job no.: **1692(AB)** Dwg. no.: **05**

Issue: **As Built** Drawn by: **dgs**

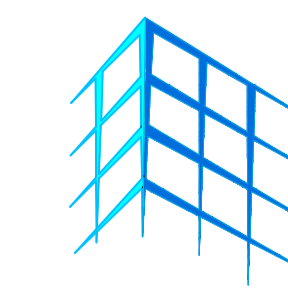

**Mackinnon & Co**  
 chartered building surveyors architectural services project managers

208 West George Street t. 0141 204 3311  
 Glasgow f. 0141 204 3391  
 G2 2PQ e. info@mackco.co.uk  
[www.mackinnon-building-surveyors.co.uk](http://www.mackinnon-building-surveyors.co.uk)