

NOTES:
 Do Not Scale.
 Report all discrepancies, errors and omissions.
 Verify all dimensions on site before commencing any work on site or preparing shop drawings.
 All materials, components and workmanship are to comply with the relevant British Standards, Codes of Practice, and appropriate manufacturers recommendations that from time to time shall apply.
 For all specialist work, see relevant drawings.
 This drawing and design are copyright of Clague LLP
 Registration number OC335948.

Rev.	Date	Description
C1	24-05-2018	Amendments as clouded further to meeting of 31st April and subsequent Client RF1 responses up to 22nd May.
C2	25-05-2018	Door ED11 added to service riser.
C3	27-07-2018	Door DG066 added to Client request. Door openings set out revised to suit door amendments.
C4	15-10-2018	Partitions amended to suit Dixon's comments up to 10/10/2018
C5	27-11-2018	Updated to suit client comments up to 27/11/18
C6	xx-04-2019	Issued as record drawing
C7	10-02-2021	AS BUILT
P1	09-02-2018	Work in progress GA Issue
P2	23-02-2018	Partitions amended
P3	26-02-2018	Details updated further to DTM 26/02 incl. service risers set out to suit SM intake positions.
P4	15-03-2018	Updated to SM revised layout received 15.03.18. Single Escape door width increased to min. 1m clear as clouded.
P5	23-03-2018	GF Product Exchange swapped with Warehouse Office, Chemical Store swapped with Hand Wash, all to Client Instruction
P6	16-04-2018	Lift shaft sizes updated to suit confirmed Olympic Lifts. Slab edge line moved to Dixon Instruction as noted.
P7	18-04-2018	Drawing status updated to S4 and issued for Construction Approval

RECORD DRAWING

This drawing has been updated by Clague LLP based on information supplied by the Contractor at completion of the building work for inclusion in the Health & Safety File.

Clague LLP cannot guarantee the accuracy of all the information shown.

Future users of this drawing must satisfy themselves on the correctness of the information shown.

NOTES ON LAYOUTS
 FOR INTERNAL PARTITION/WALL TYPES SEE CLAGUE DRAWINGS PL(00)_047, 048, 057 & 058.
 ALL INTERNAL STEELWORK TO BE ENCASED TO ACHIEVE 60 MINUTE FIRE PROTECTION OF STRUCTURE UNLESS OTHERWISE INDICATED.
 FOR PARTITION DEFLECTION/BASE/HEAD DEFLECTION DETAILS SEE DRAWINGS 23287A/CD(00)_41, 42 & 43.
 CLEAR DIMENSIONS TAKEN TO FACE OF PARTITION NOT INCLUDING WALL FINISH.
 SEE ROOM DATA SHEET FOR ROOM DETAILS. ROOM NUMBER, REF (R) FOR SHEET NO., REF (D)

AS BUILT

Project Title
Omega Diagnostics
 Unit C Wellington Road,
 Lancaster Way Business Park,
 Ely,
 CB6 3NX

Drawing Description
Proposed Ground Floor

Scale
 As indicated @A1

Drawn by
 CAW/MP

Date
 Jan 18

Checked by
 AB

CLAGUE ARCHITECTS

62 Burgate, Canterbury
 Kent CT1 2BH 01227 762060


1 Kinsbourne Court, Luton Road,
 Harpenden, Hertfordshire AL5 3BL 01582 765102

8, Disney Street
 London SE1 1JF 0203 597 6112

CANTERBURY LONDON HARPENDEN

Drawing Number
 23287A_PL(00)_04

Revision
 C7

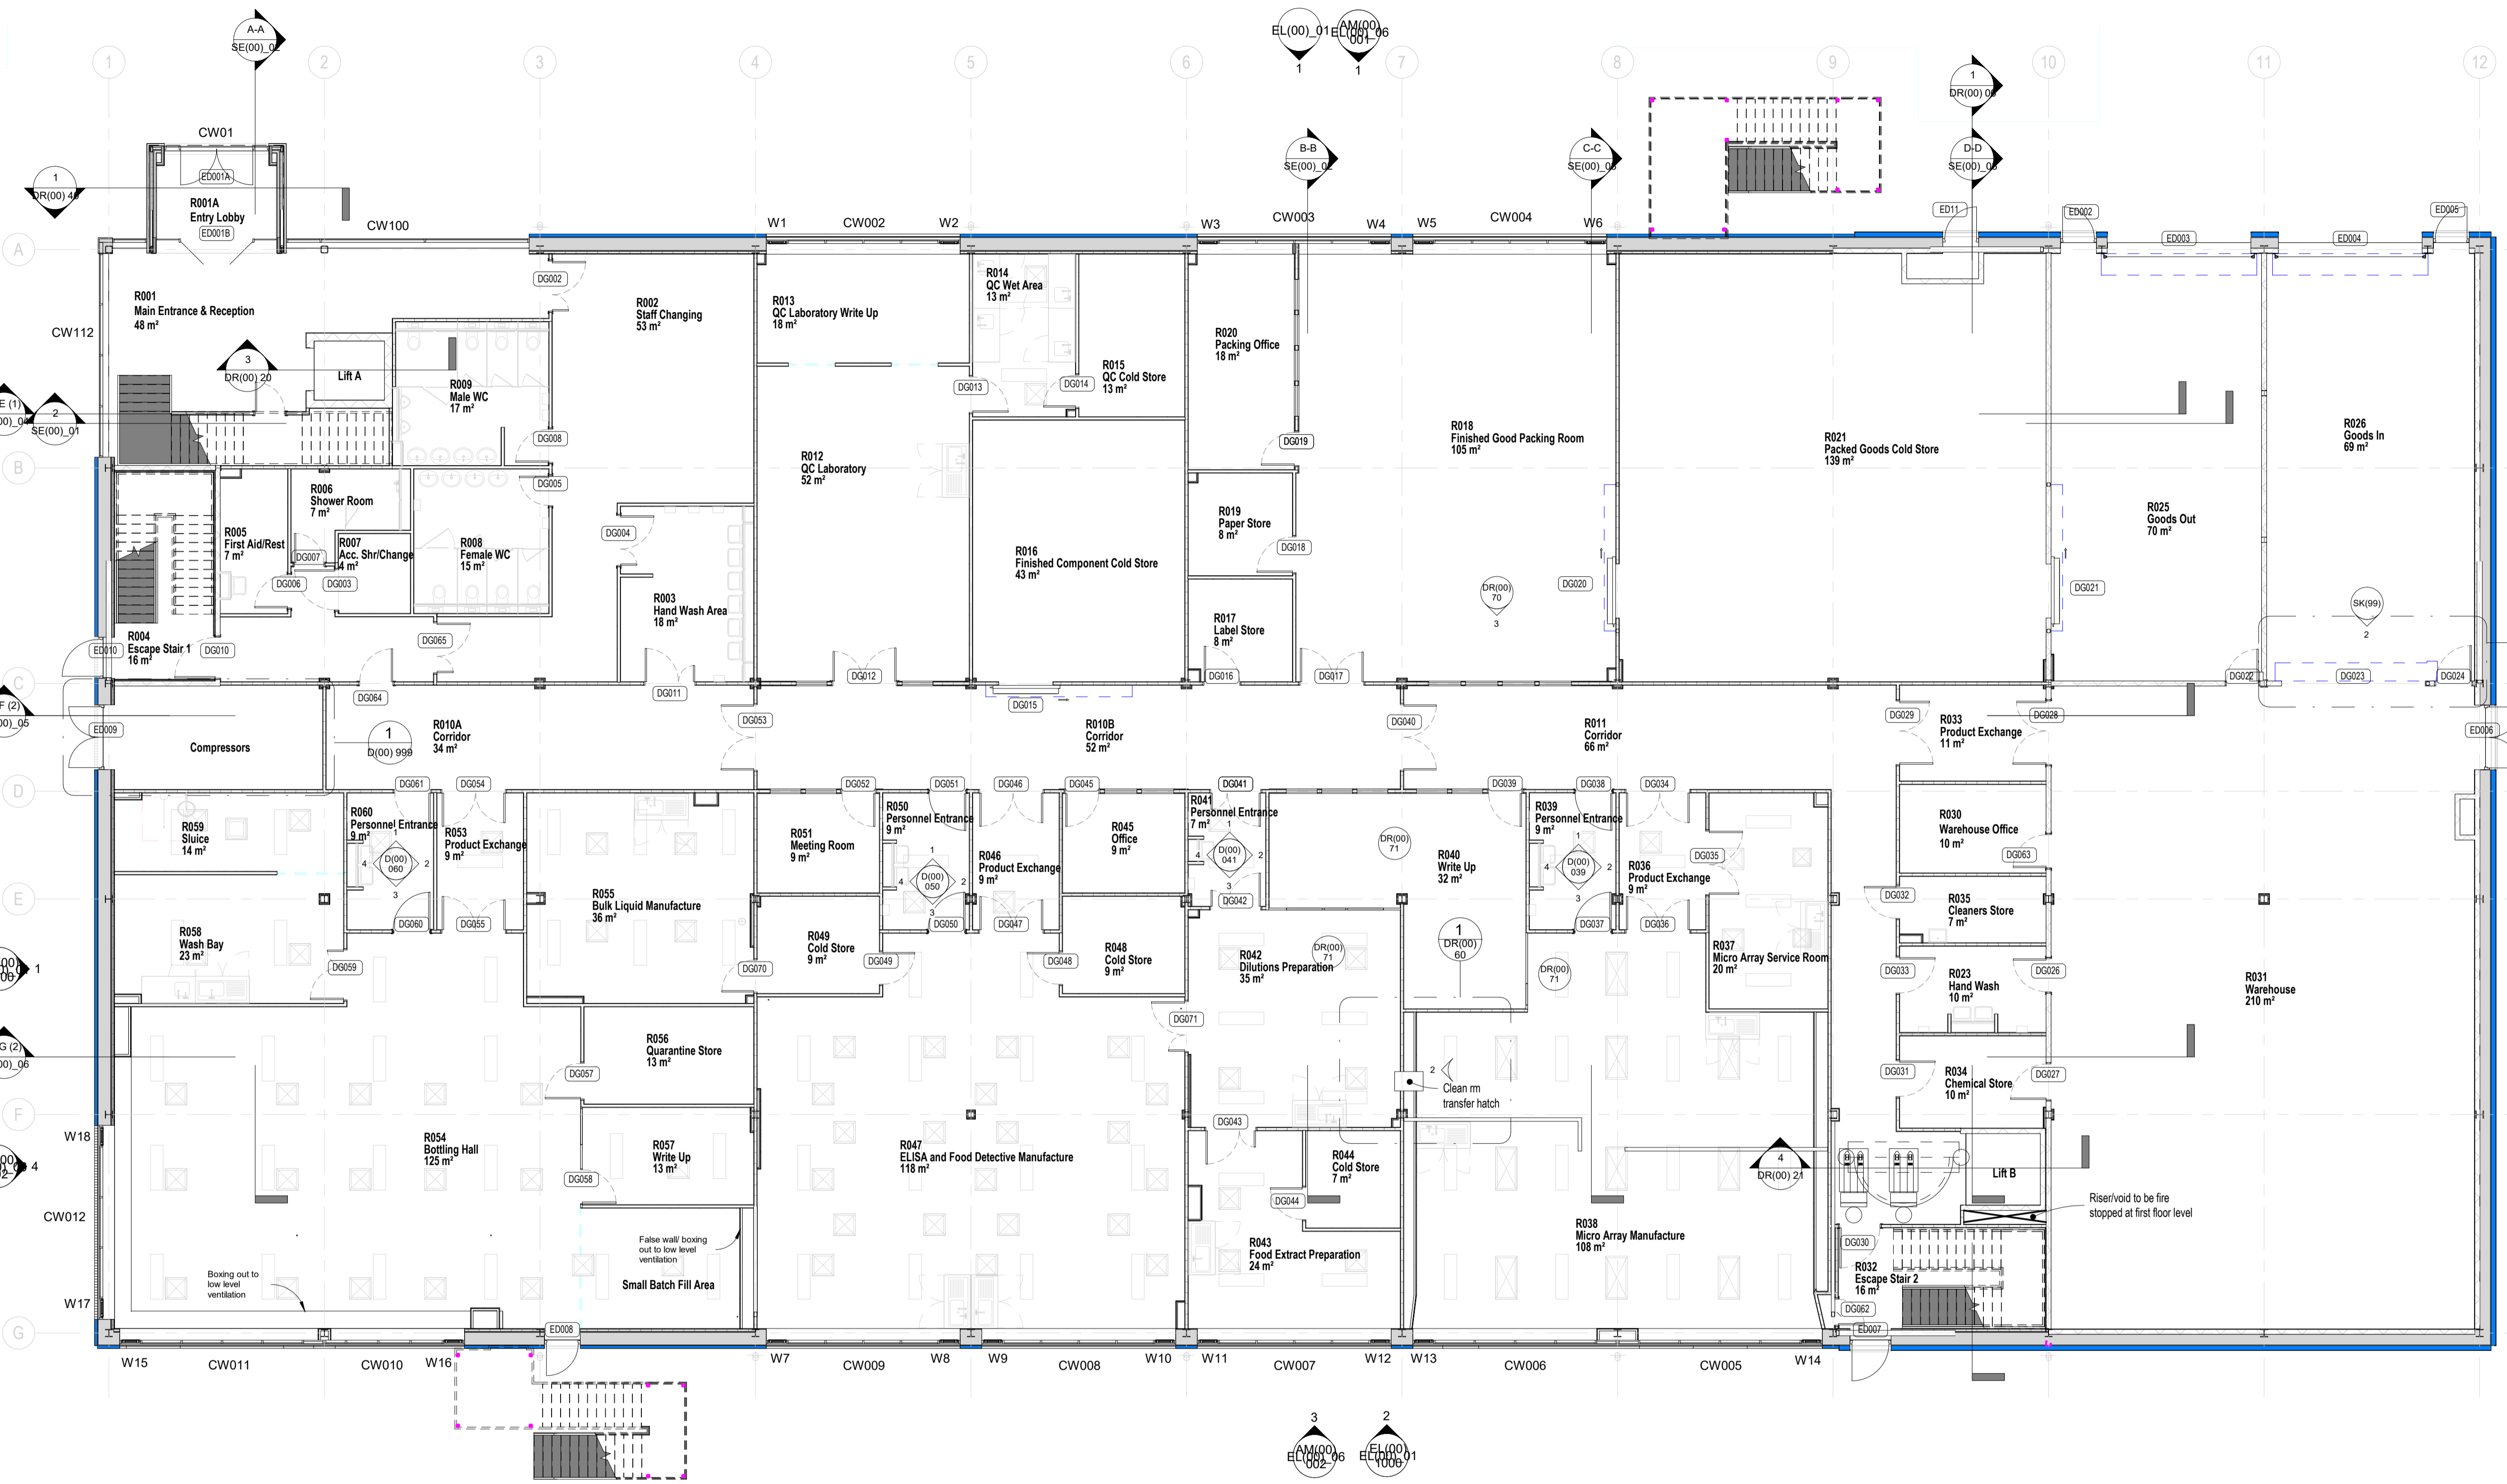

Ground Floor Plan
 1:100

